
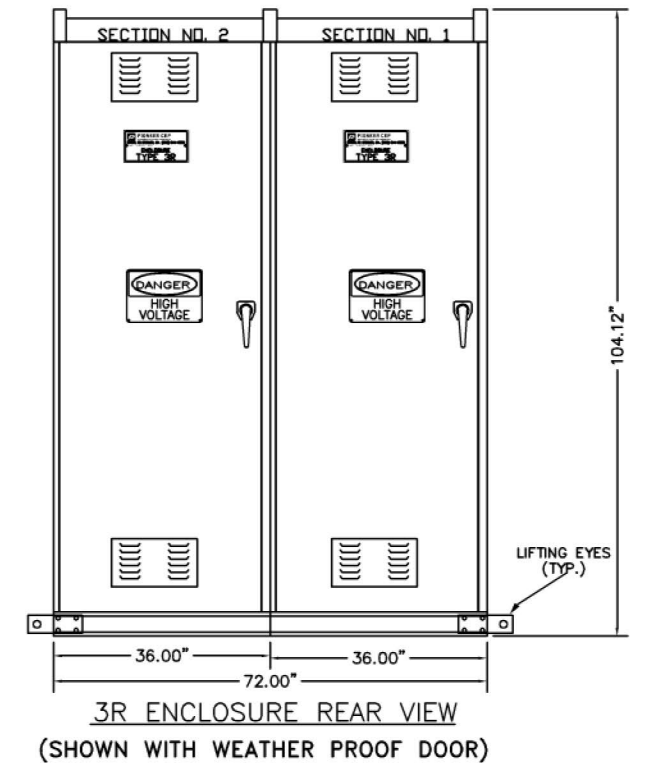
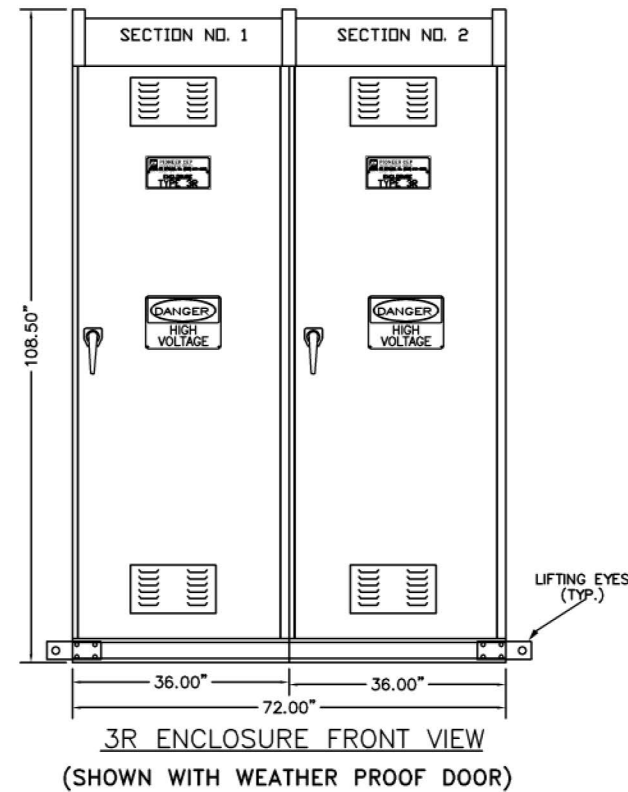
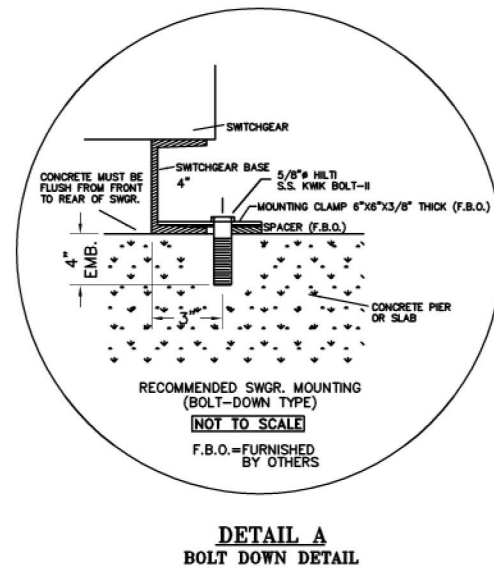
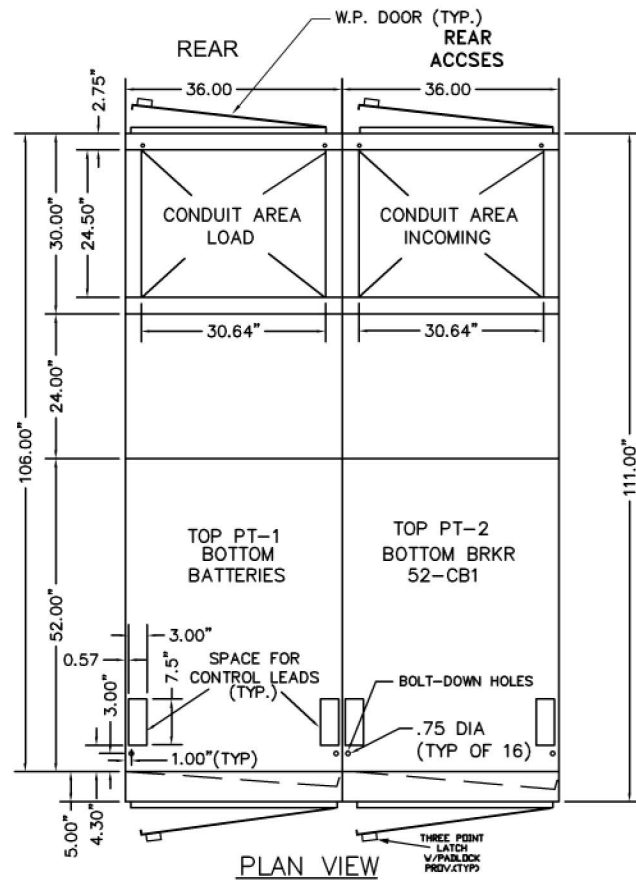
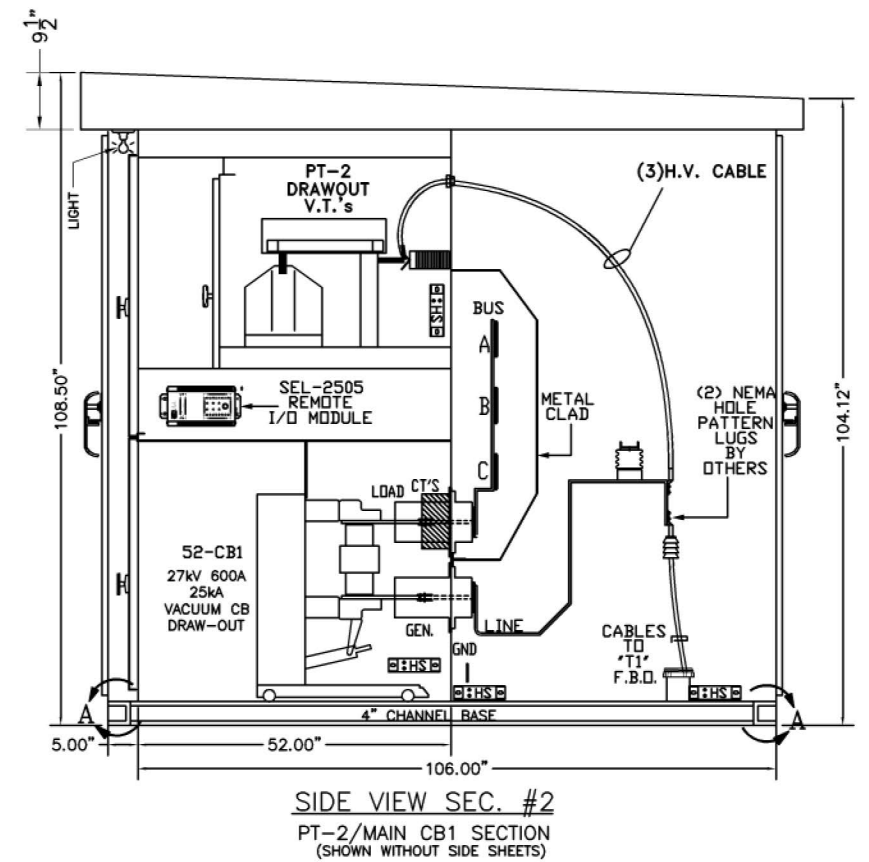
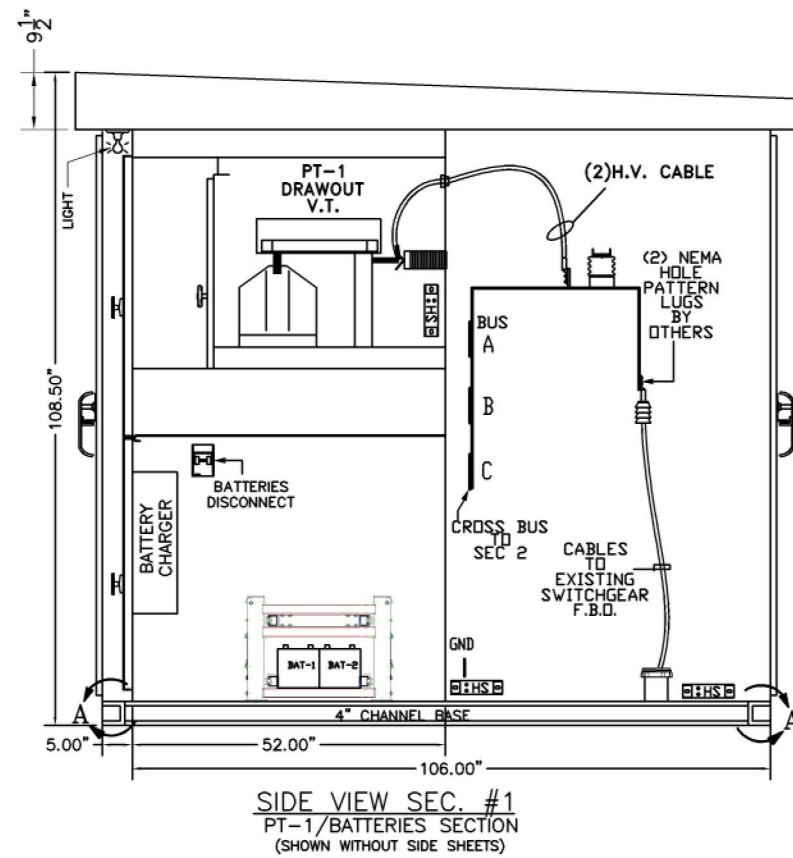


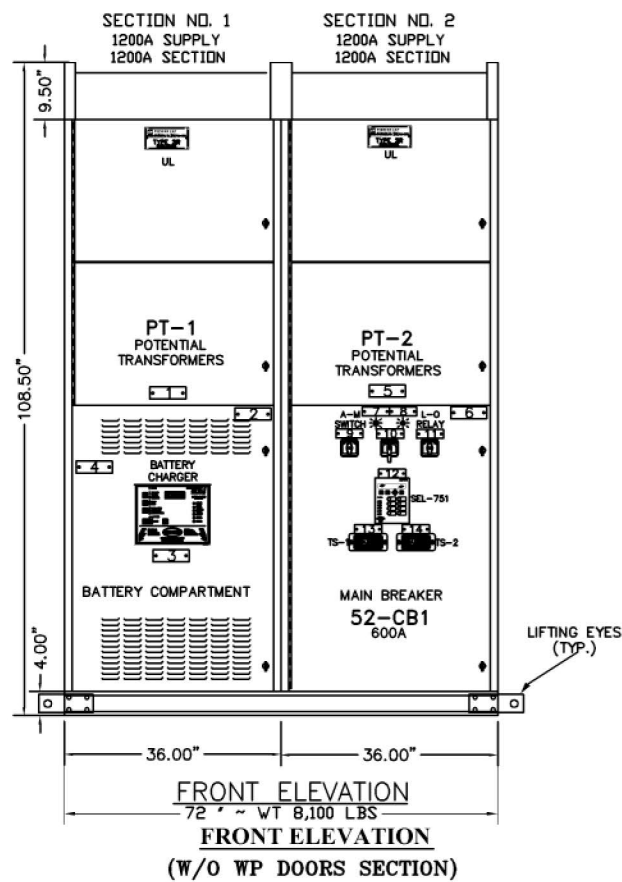

TOTAL APPROXIMATE WEIGHT = 8,100 LBS

PIONEER CEP
CUSTOM ELECTRICAL PRODUCTS
10640 Springdale Ave. Santa Fe Springs, CA 90670
www.pioneercep.com

DRAWN BY: FA
APPROVED BY: -
REVIEWED BY: -
PROJECT ENGINEER: FA

DATE: 11-11-16
DATE: -
DATE: -

TITLE: NON-WALKIN TYPE 3K METAL CLAD SWITCHGEAR PER C37.202
600A 25kV 3PH 3W 60Hz 125kV B.I.L. 17.5kA
DISTRIBUTOR: T&B
CONTRACTOR: DWG. NO.
SCALE: NONE
SHEET: 1 OF 1

REV. D

REV.	DATE	DESCRIPTION	BY	REV.	DATE	DESCRIPTION	BY	REV.	DATE	DESCRIPTION	BY
-	-	-	-	D	03/31/17	AS BUILT	SSD	B	02/06/17	REVISED ENCLOSURE REAR COVERS TO DOORS	FA
-	-	-	-	C	02/07/17	REVISED PER ENGINEERING DESIGNER REVIEW	M-G	A	12/22/16	REVISED PER SUBMITTAL REVIEW (11/27/16)	FA