



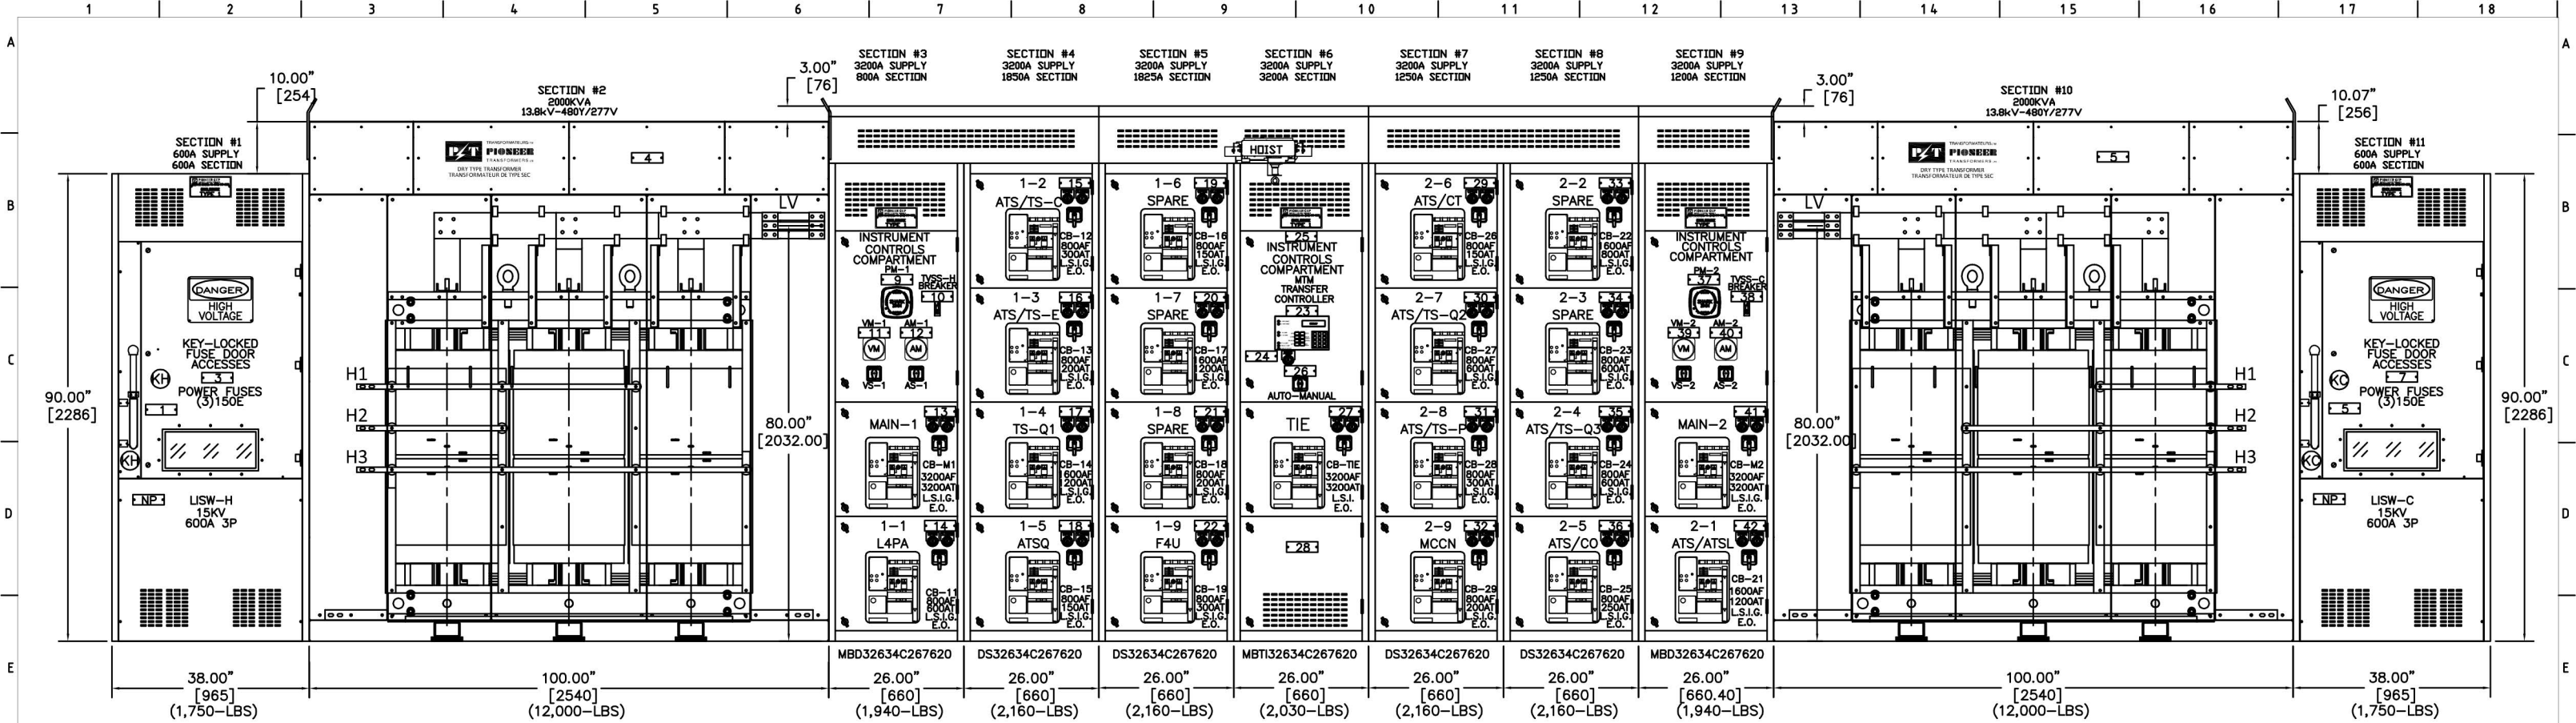

FRONT ELEVATION
TOTAL APPROX. WEIGHT = 42,050 LBS

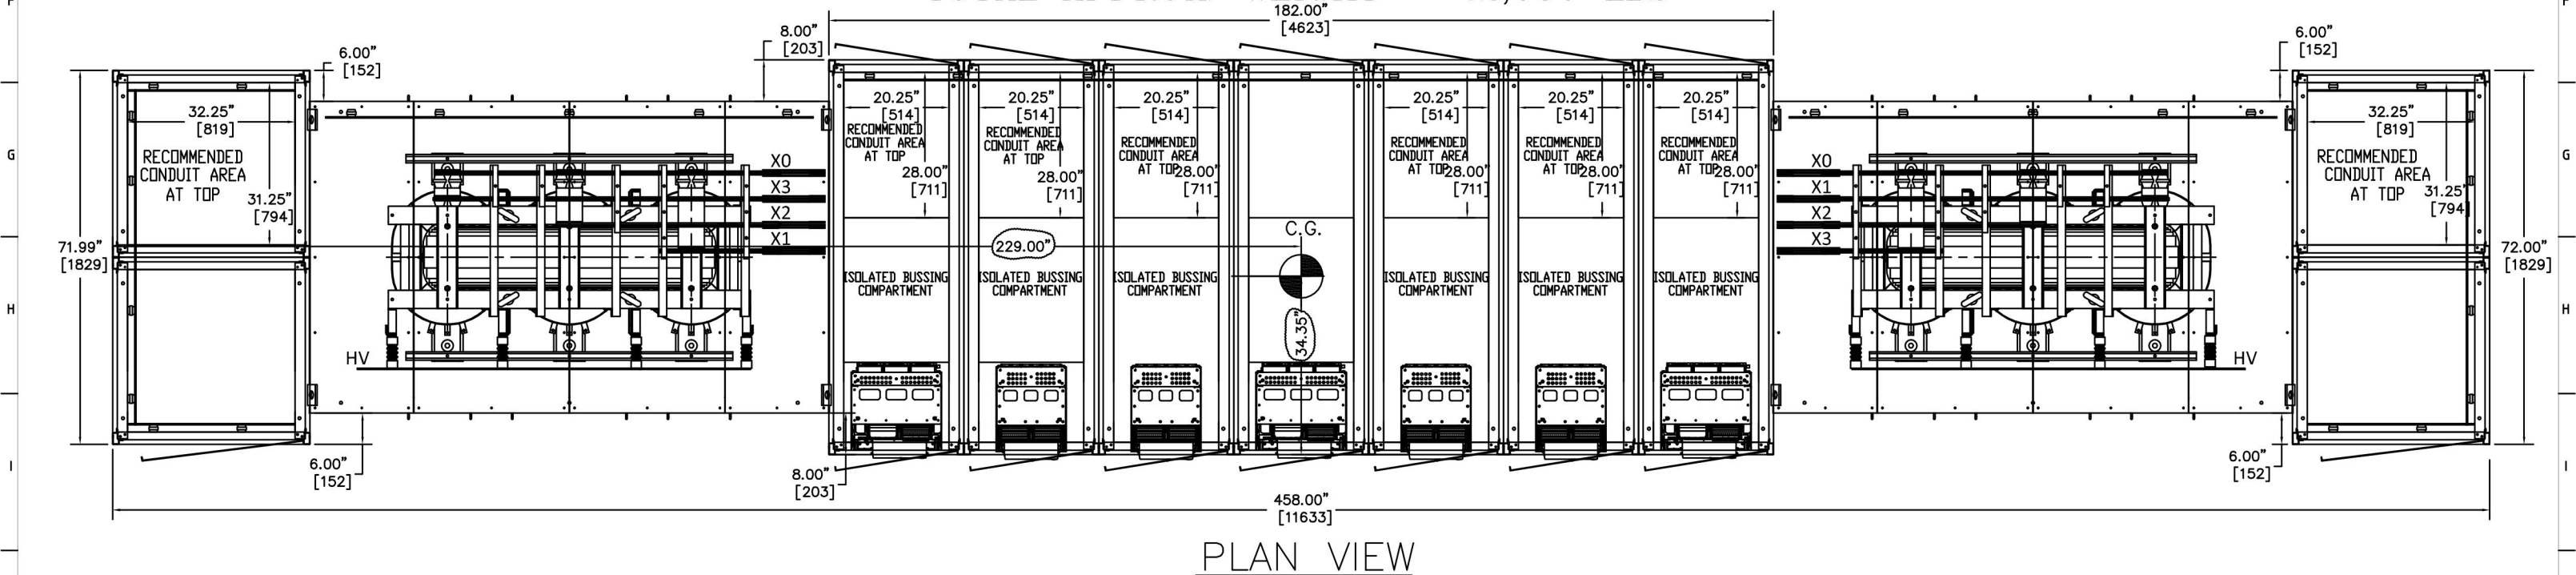

PLAN VIEW

PIONEER CEP
CUSTOM ELECTRICAL PRODUCTS
10640 Springdale Ave. Santa Fe Springs, CA 90670
www.pioneercep.com

DRAWN BY: FA	DATE: 10/16/15	TITLE:
APPROVED BY: -	DATE: -	TYPE 1 SWITCHBOARD 3200A 480Y/277V 3PH 4W 65kA FRONT ELEVATION AND PLAN VIEW
REVIEWED BY: -	DATE: -	DWG. NO. 1
PROJECT ENGINEER: FA		REV. B
		CAD FILE: 50596 SCALE: NONE SHEET: 3 OF 18

-	-	-	-	B	12/16/16	REVISED (ADD WEIGHT & CENTER OF GRAVITY)	-
-	-	-	-	A	1/15/16	AS BUILT	FA
REV.	DATE	DESCRIPTION	BY	REV.	DATE	DESCRIPTION	BY